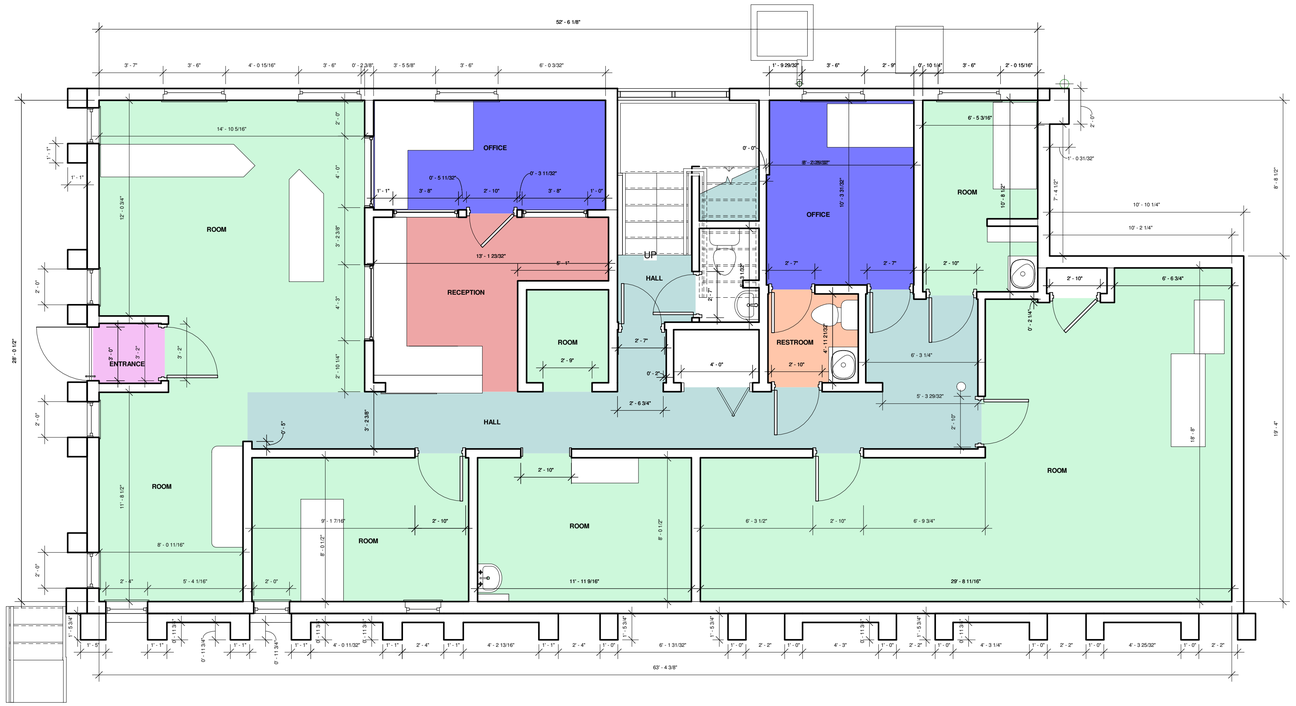

1 UNDER GROUND
1/4" = 1'-0"

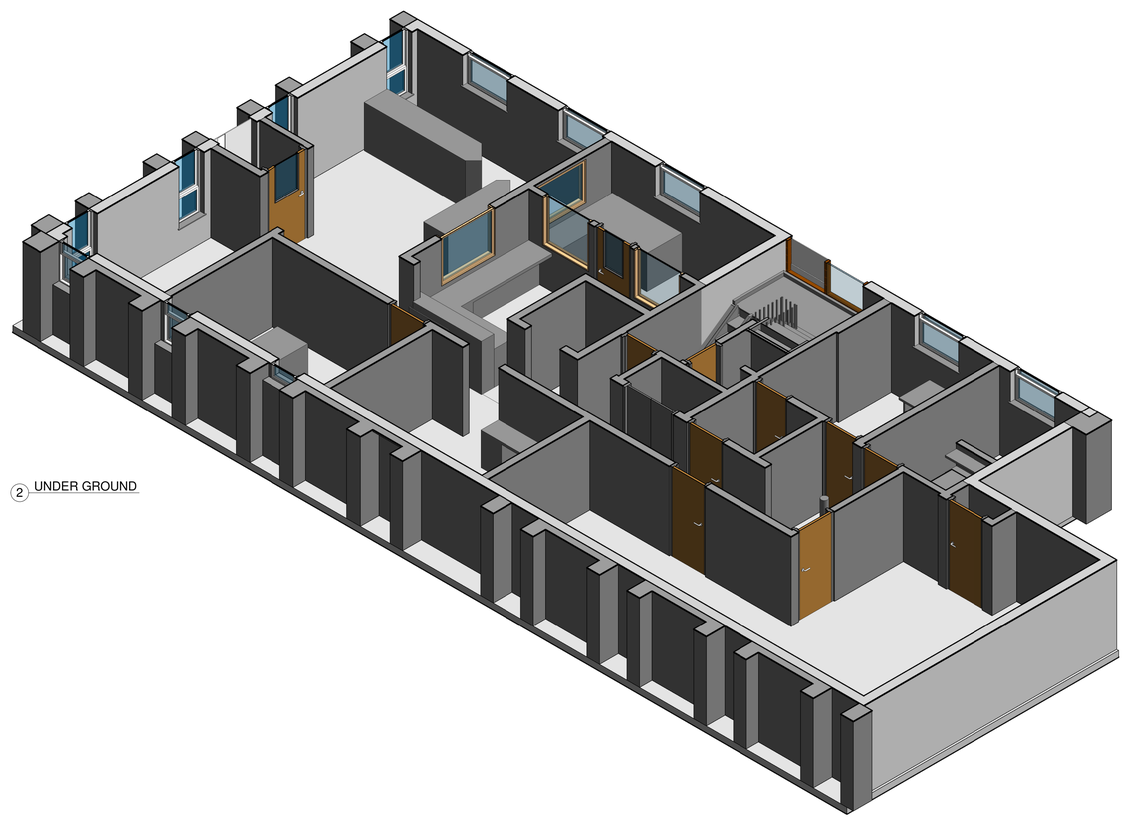

2 UNDER GROUND

S3D ENGINEERING

REVISIONS

No.	Description	Date

AS BUILT

12 N AIRMONT RD

UNDER GROUND

Project #

Date 09-05-2022

Drawn by

Checked by

Scale 1/4" = 1'-0"

A100

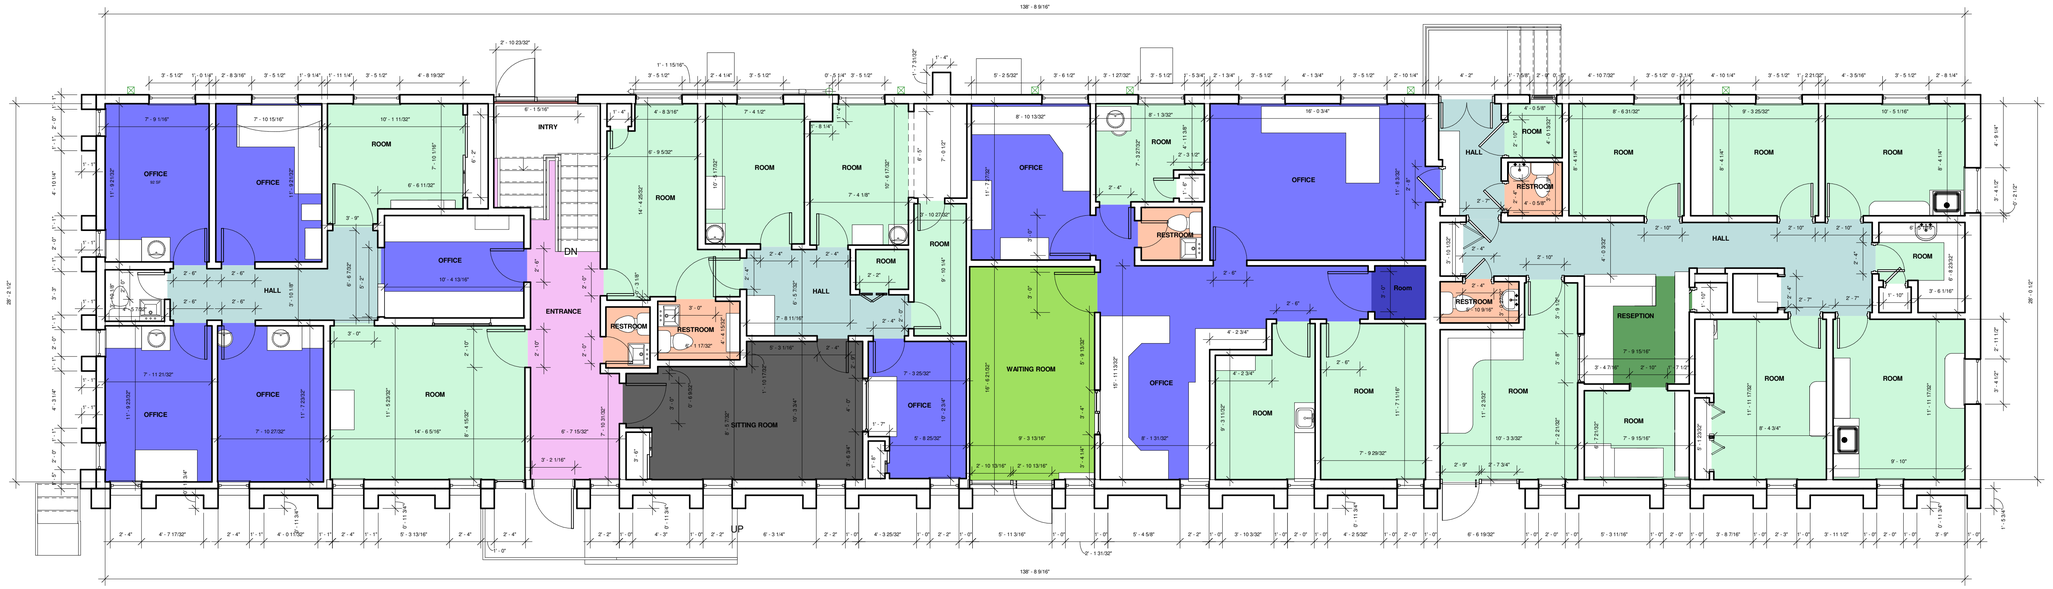

1 FLOOR 1
3/16" = 1'-0"

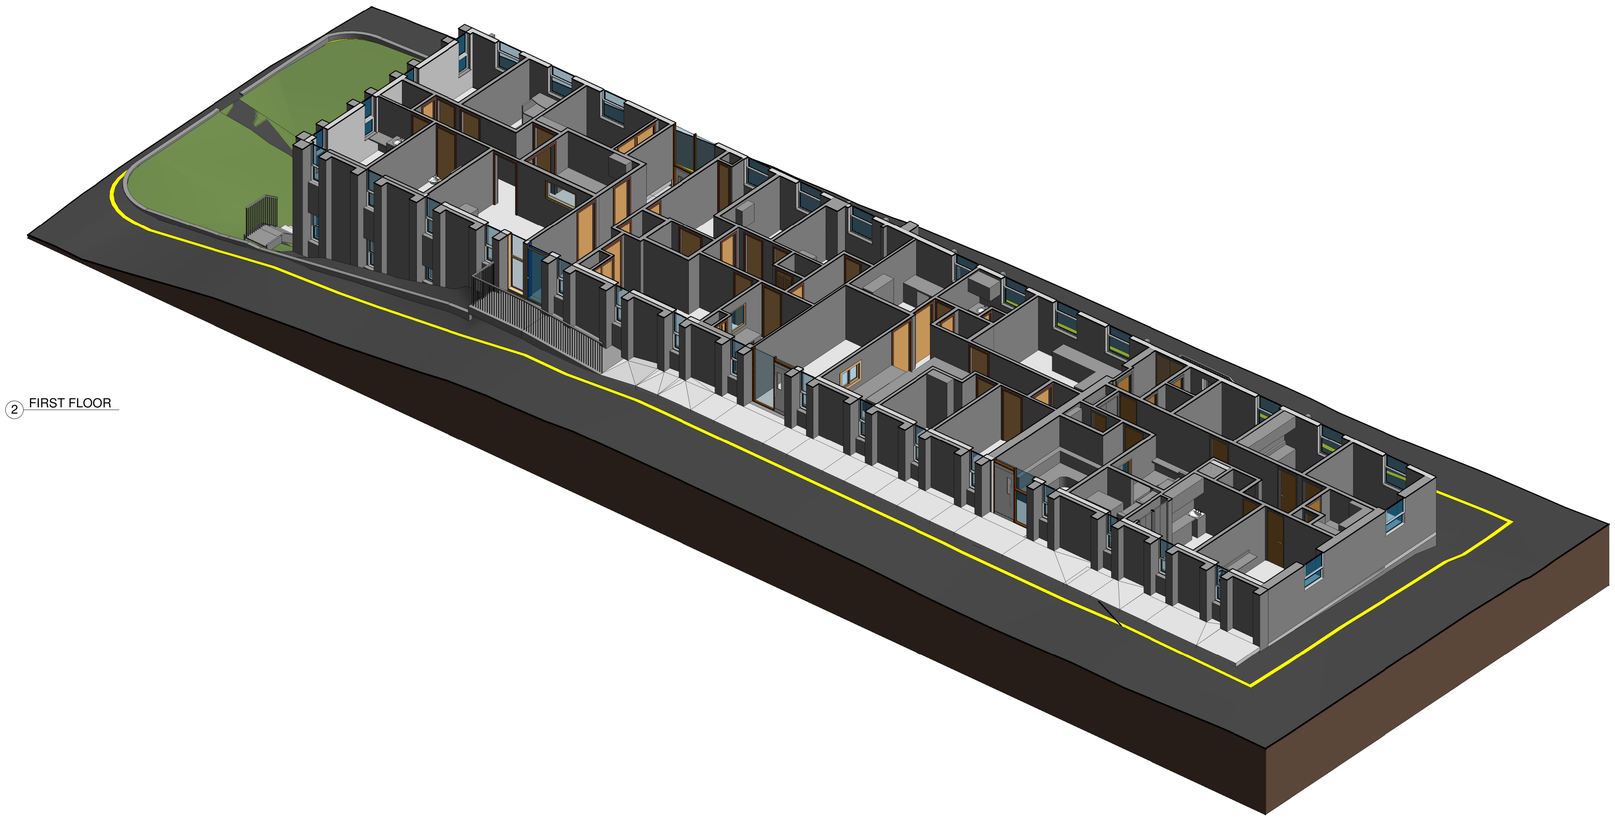

2 FIRST FLOOR

REVISIONS

No.	Description	Date

AS BUILT

12 N AIRMONT RD

FLOOR 1

Project #

Date 09-05-2022

Drawn by

Checked by

Scale 3/16" = 1'-0"

A101

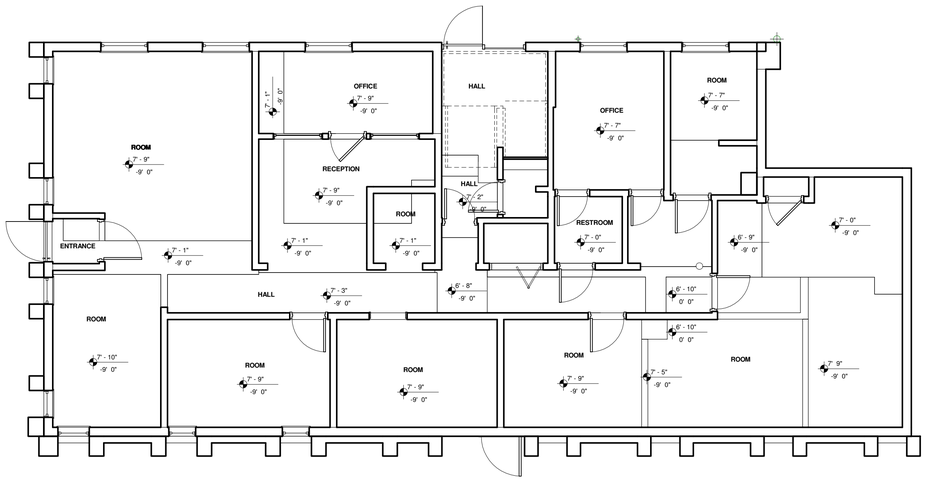

1 UNDER GROUND CEILING PLAN
3/16" = 1'-0"

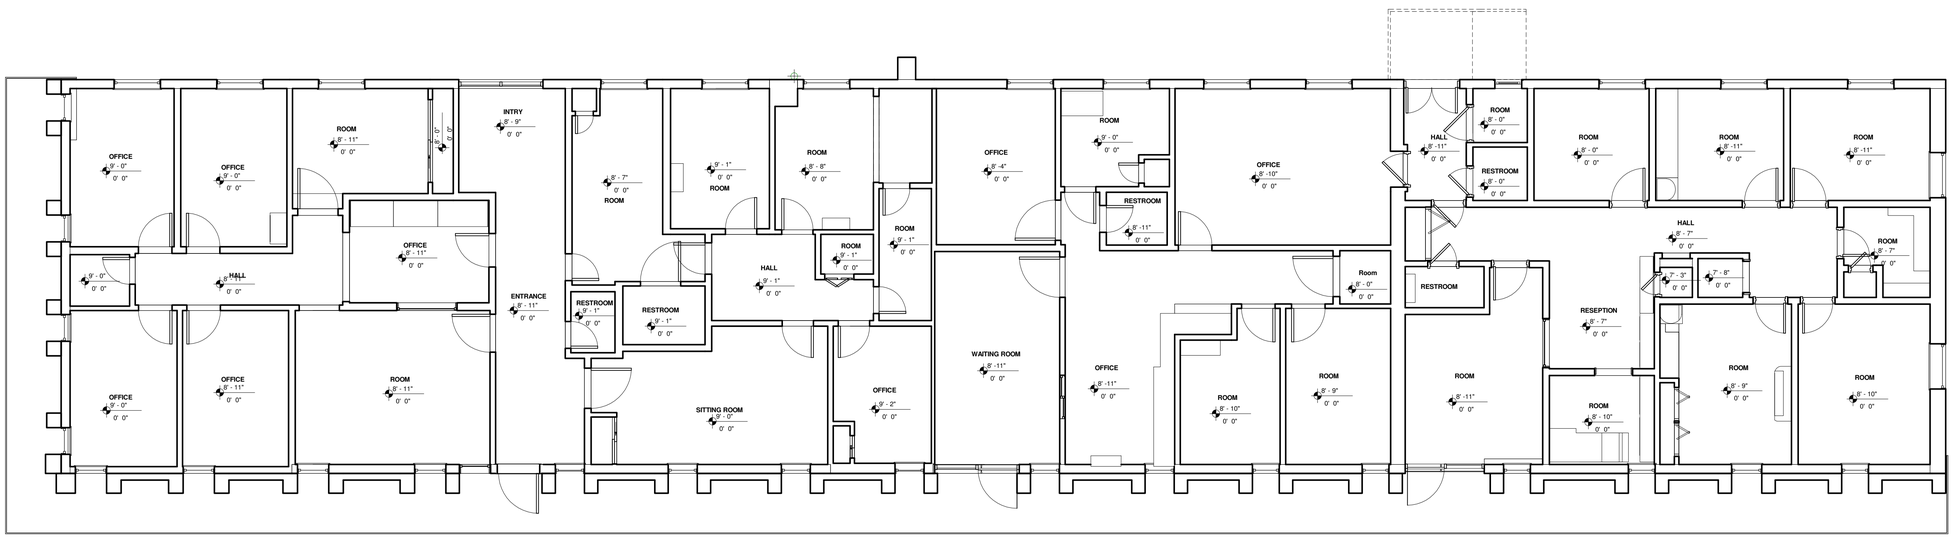

2 FLOOR 1 - CEILING PLAN
3/16" = 1'-0"

S3D ENGINEERING

REVISIONS

No.	Description	Date

AS BUILT

12 N AIRMONT RD

CEILING PLAN 1&2

Project #

Date 09-05-2022

Drawn by

Checked by

Scale 3/16" = 1'-0"

A102

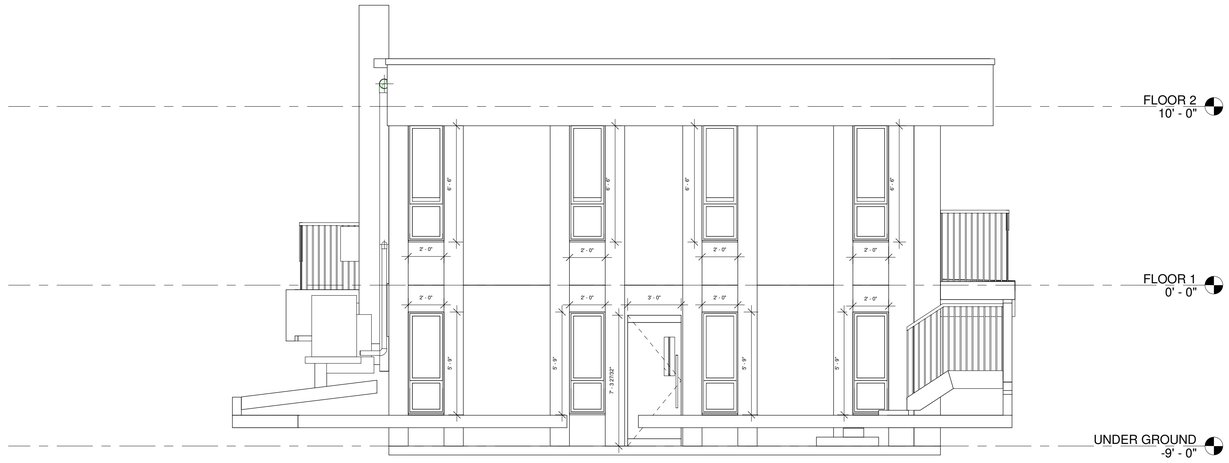

1 ELEVATION 1
1/4" = 1'-0"

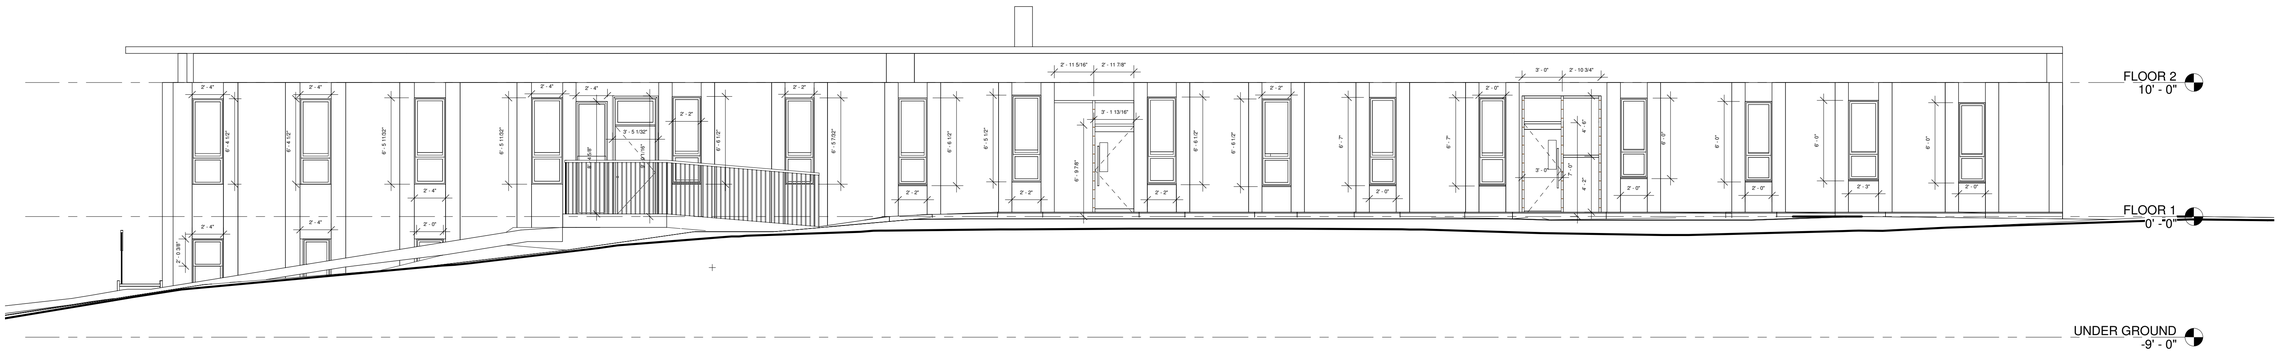

2 ELEVATION 2
3/16" = 1'-0"

S3D ENGINEERING

REVISIONS

No.	Description	Date

AS BUILT

12 N AIRMONT RD

ELEVATION

Project #

Date 09-05-2022

Drawn by

Checked by

Scale As indicated

A200

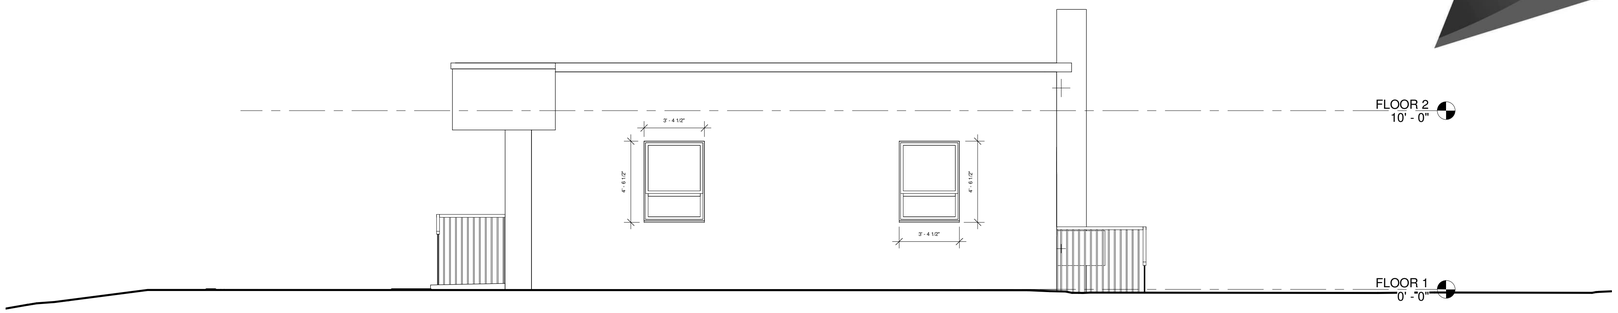

1 ELEVATION 3
1/4" = 1'-0"

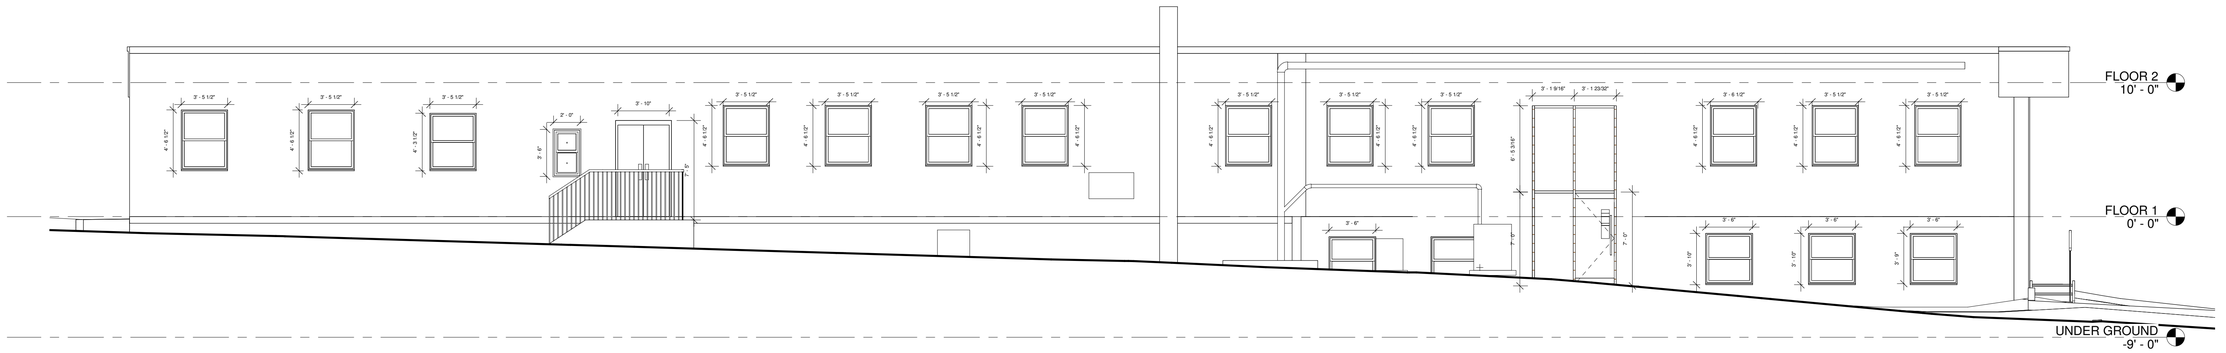

2 ELEVATION 4
3/16" = 1'-0"

S3D ENGINEERING

REVISIONS

No.	Description	Date

AS BUILT

12 N AIRMONT RD

ELEVATION

Project #

Date 09-05-2022

Drawn by

Checked by

Scale As indicated

A201

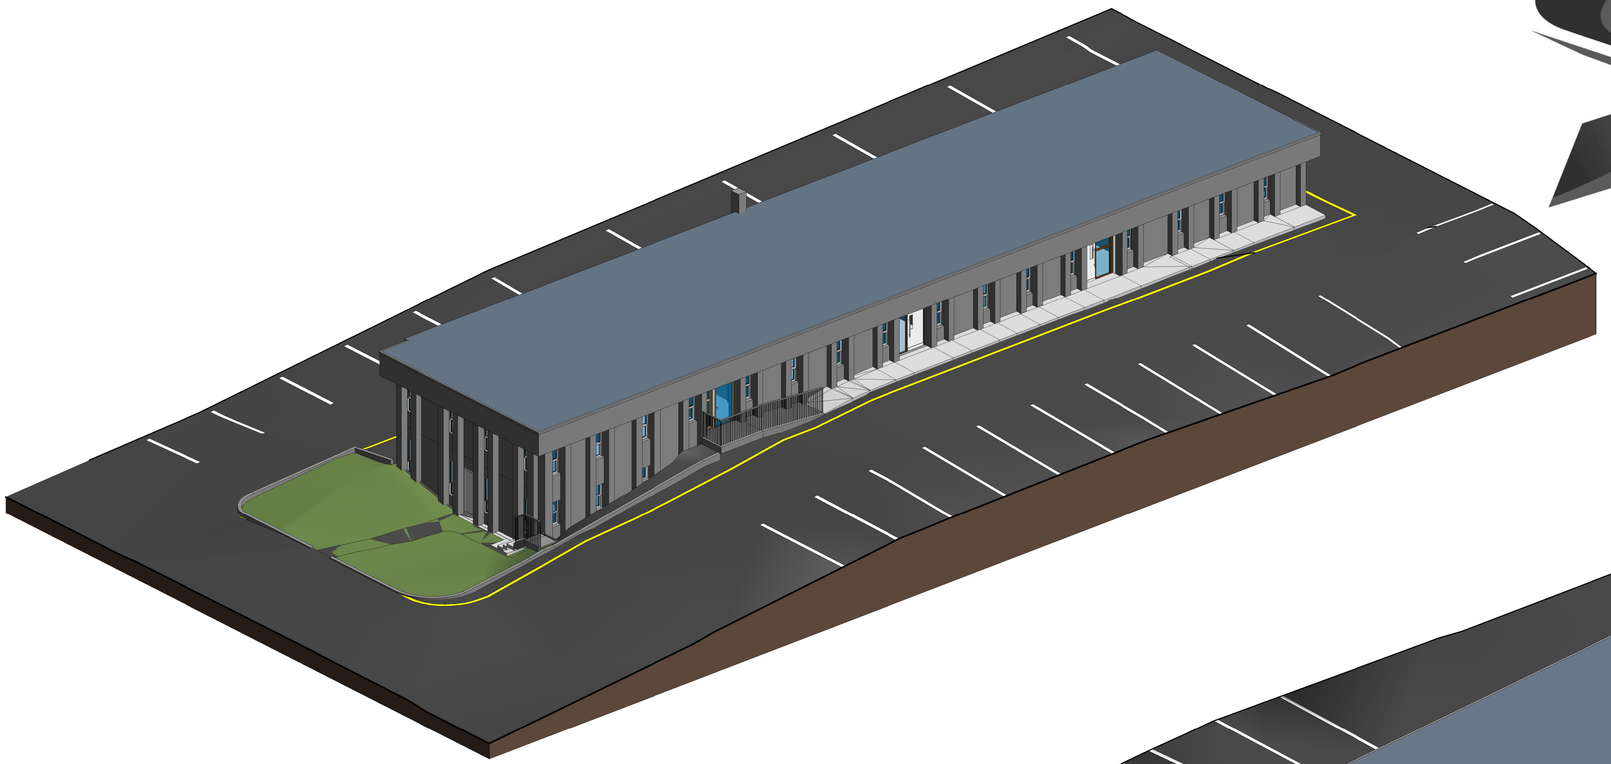

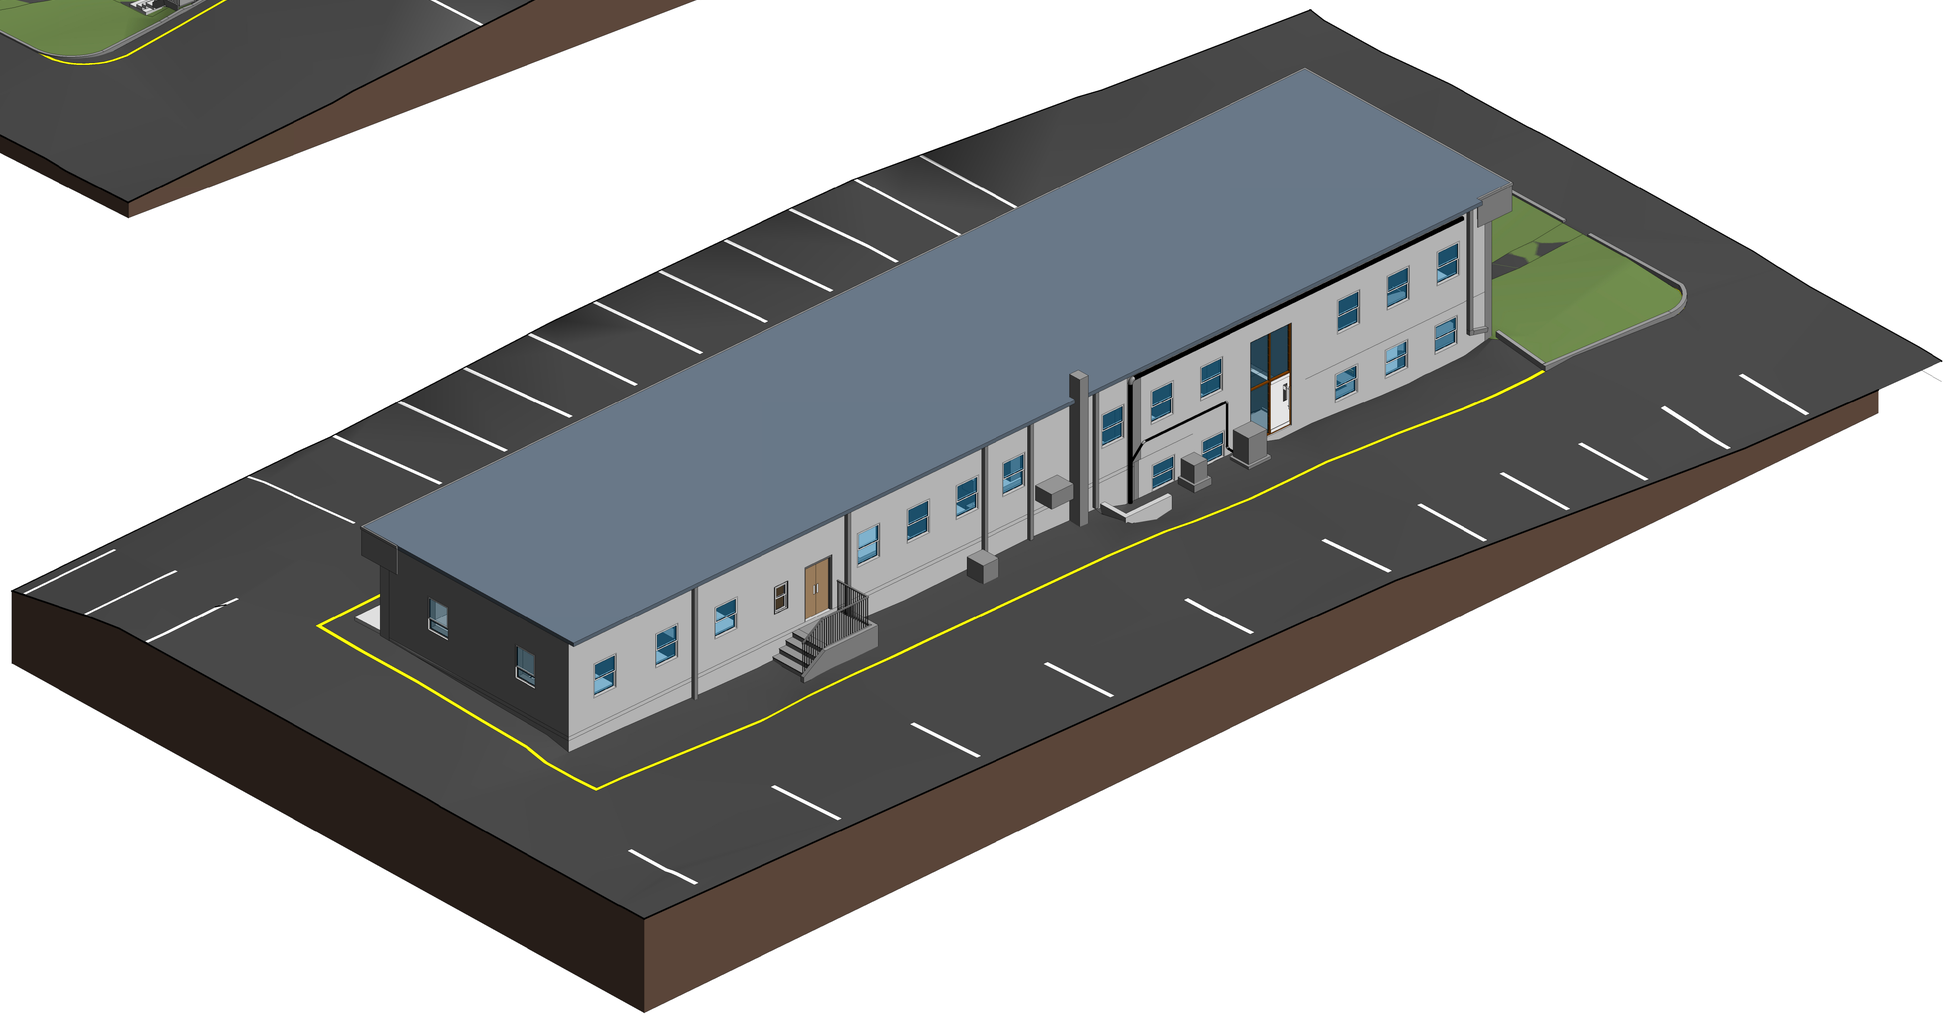

S3D ENGINEERING

REVISIONS

No.	Description	Date

AS BUILT

12 N AIRMONT RD

3D VIEWS

Project #

Date 09-05-2022

Drawn by

Checked by

Scale

A300